 


MARINA





MARINA

Emplaçament






MARINA

Concurs

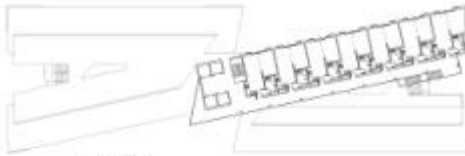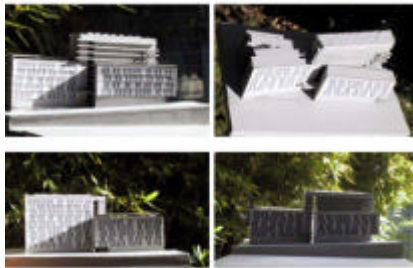


MARINA

Concurs

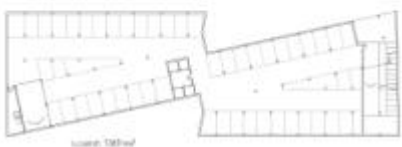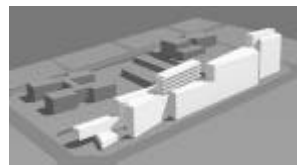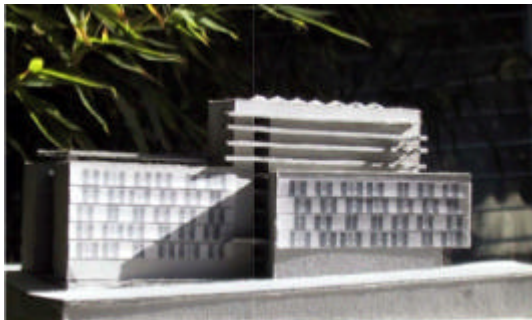


MARINA



Detalls Constructius

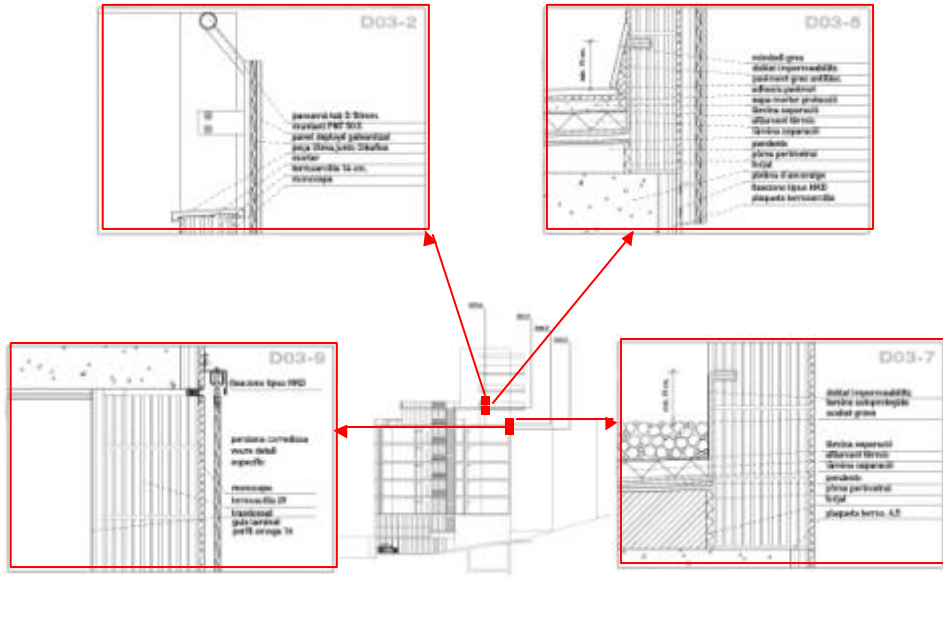

MARINA


Detalls Constructius
AMBASCIATTA

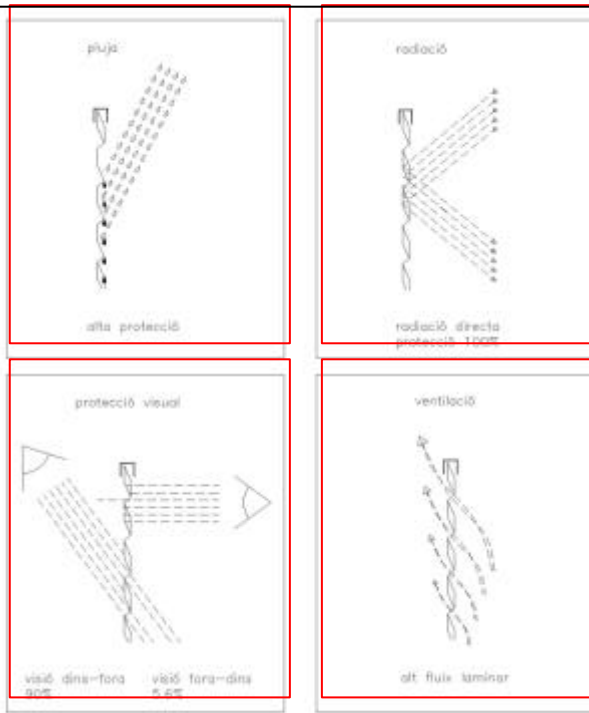

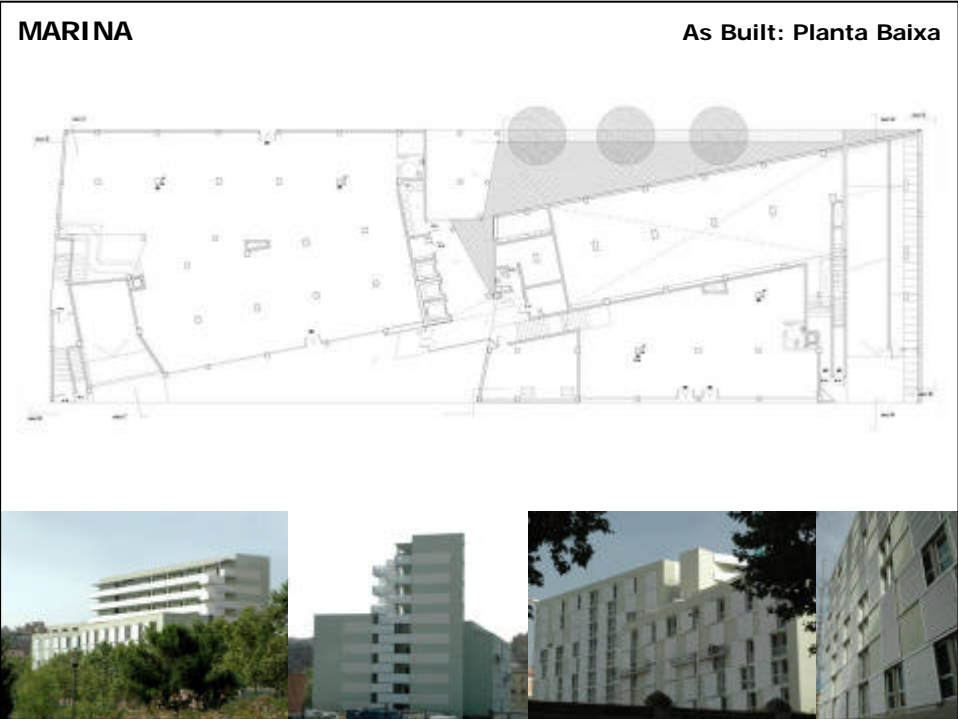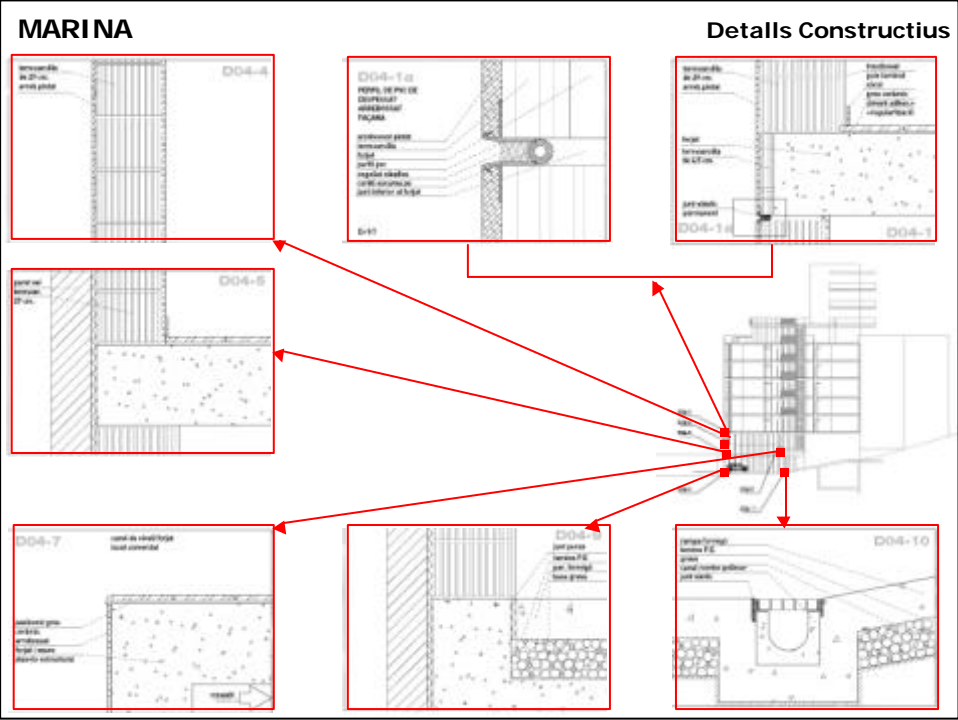


MARINA

As Built: Planta Tipus

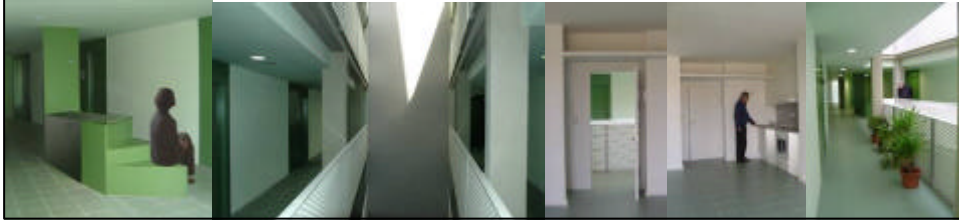

MARINA

As Built: Plantes Superiors

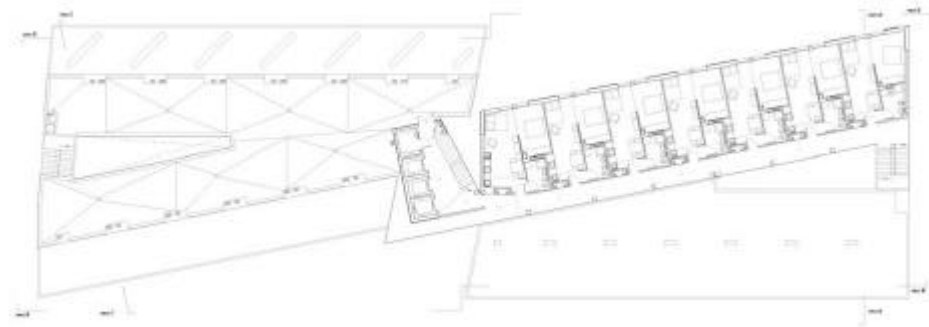

MARINA

Obra

